BOROUGH OF JESSUP LACKAWANNA COUNTY, PENNSYLVANIA ORDINANCE No. 4-2023

AN ORDINANCE AMENDING ORDINANCE NUMBER 10 OF 2020, AS AMENDED, ENTITLED THE "BOROUGH OF JESSUP ZONING ORDINANCE", AMENDING ARTICLE 2, SECTION 202 ENTITLED "ZONING MAP" AS WELL AS THE OFFICIAL ZONING MAP OF THE BOROUGH OF JESSUP DATED NOVEMBER 23, 2020 ATTACHED THERETO, CHANGING A PORTION OF LAND FROM ZONING DESIGNATION IC TO C-R AND A PORTION OF LAND FROM ZONING DESIGNATION LI TO C-R

WHEREAS, the Borough of Jessup is a duly ordained and existing political subdivision organized under the laws of the Commonwealth of Pennsylvania, particularly, the Pennsylvania Borough Code; and

WHEREAS, the Borough of Jessup has in effect Ordinance Number 10 of the year of 2020, otherwise known as the "Borough of Jessup Zoning Ordinance" as amended to date; and

WHEREAS, Jessup Borough Council has duly discussed, legally advertised and held public hearings in accordance with the Pennsylvania Municipalities Planning Code as well as said Ordinance of its intention to amend said Ordinance in accordance with the terms and conditions outlined herein.

NOW, THEREFORE, be it hereby ordained and enacted by the Jessup Borough Council pursuant to the authority granted to it under the laws of the Commonwealth of Pennsylvania, as follows:

- 1. **Zoning Designation Change** The official Jessup Borough Zoning Map dated November 23, 2020, as well as Article 2, Section 202, entitled "Zoning Map" is hereby amended to reflect that:
 - a. the parcel of land currently designated as part of PIN No. 12602-010-001, also known as "Conservation Parcel 1" on a map recorded in the Lackawanna County Recorder of Deeds Office on January 27, 2023 to Instrument Number 202301280 at Map Book 6AM, Page 12005, a portion of which is currently zoned as C-R and a portion of which is currently zoned as IC, on the aforesaid Jessup Borough Zoning Map, is hereby changed and further designated as zoning designation C-R for the entire parcel.
 - b. the parcel of land currently designated as part of PIN No. 12602-010-001, also known as "Conservation Parcel 2" on a map recorded in the Lackawanna County Recorder of Deeds Office on January 27, 2023 to Instrument Number 202301280 at Map Book 6AM, Page 12005, a portion of which is currently zoned as C-R and

a portion of which is currently zoned as LI, on the aforesaid Jessup Borough Zoning Map, is hereby changed and further designated as zoning designation C-R for the entire parcel.

- 1.1. See **Exhibit A** attached hereto which further illustrates the zoning map change referenced above.
- 2. **Effective Date** This Ordinance shall take effect within five (5) days from the date enacted herein or upon a date as otherwise prescribed by law.
- 3. **Severability** The provisions of this Ordinance are severable. If any part of this Ordinance is declared to be unconstitutional, illegal, or invalid for whatever reason, the remaining provisions shall be unaffected and same shall remain in full force and effect. Only those provisions deemed invalid shall be stricken.
- 4. **Remaining Terms** All remaining terms and provisions of the Borough of Jessup Zoning Ordinance, as amended to date, shall remain in full force and effect and shall not otherwise be affected.
- 5. **Zoning Map Change** The official Zoning Map of the Borough of Jessup shall hereafter be amended to reflect the zoning designation change as indicated herein.

ENACTED AND ORDAINED on this 7th day of June, 2023 at a duly advertised public hearing of Jessup Borough Council.

Jessup Borough Council

By: <u>Level Janualla</u>
President

Attest: Secretary

Examined and Approved this _____ day of ______, 2023


Joseph Buckshon J. Joseph Buckshon

Mayor of Jessup


Approved as to form.

Christopher J. Szewczyk, Esq.

Borough Solicitor

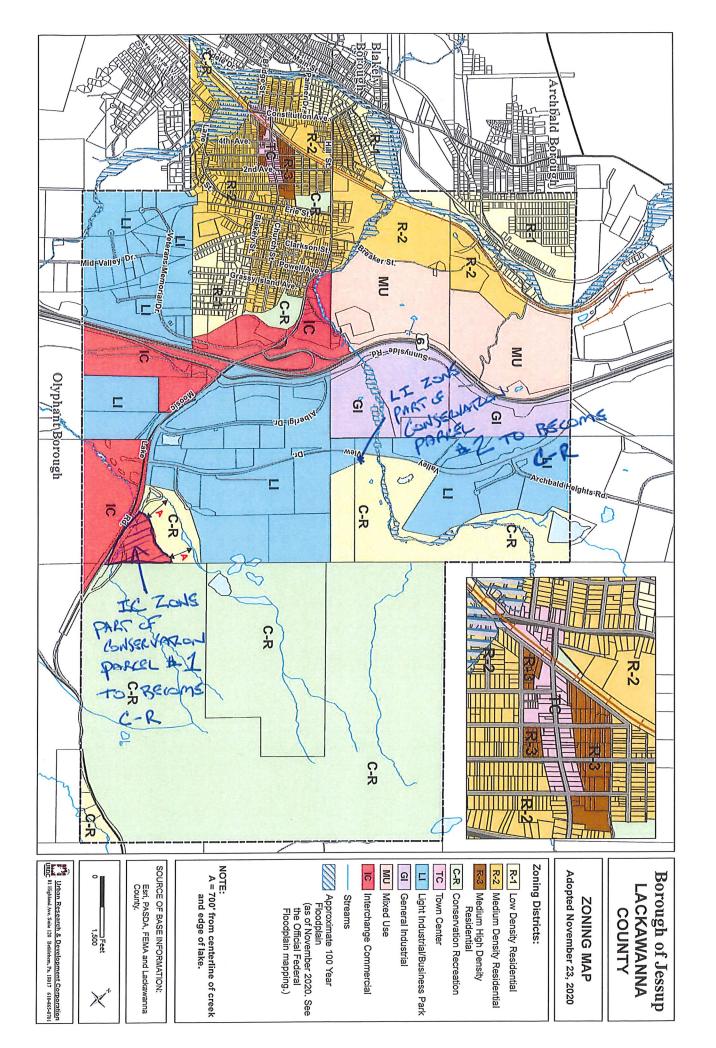

Conservation PARCEL #1

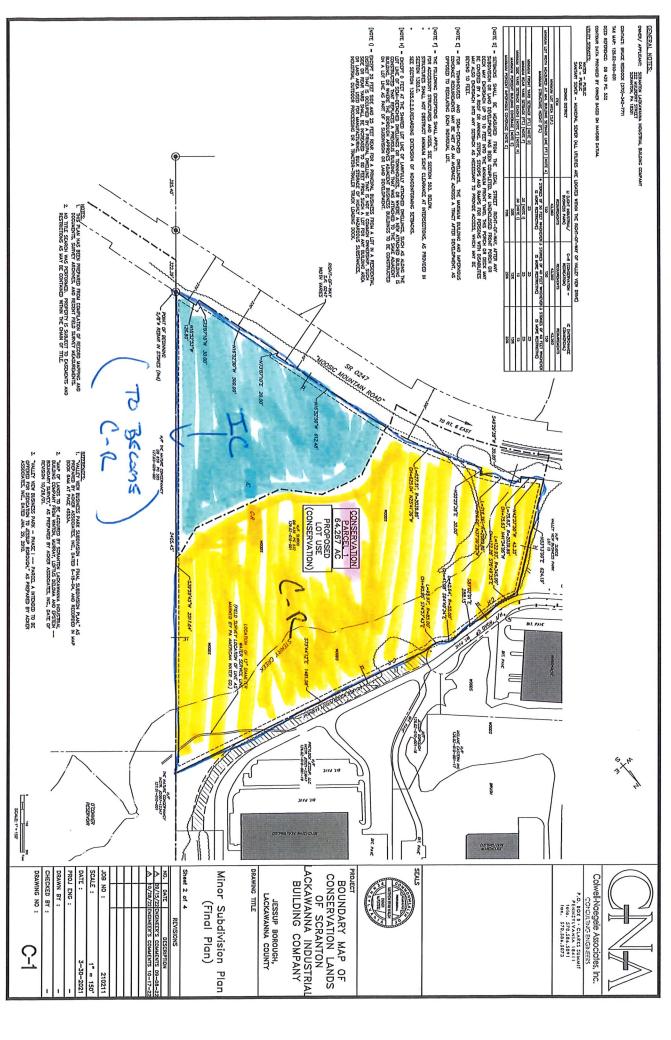

RETERMEN:

1. TRAIL TRAVE THE SUBDIVISION OF VALLEY WEN BUSINESS

1. TRAVE THE ASS PROMISED YOU DESCH PARTNESS,

1. TRAVE TO THE SUBDIVISION IN MAY BOOK MAN AT

PAGE TYXIN. IN STONES "ALP OF LANDS TO BE ACCURED BY STRANTIN LOCKHANNAN NOUSTEAL BUILDING COMPANY FROM MINTON, MERCH, OFTES DELMA MOD OSTEN — BOMODAYY SURFER! AS PREPARED BY ACCES ASSOCIATES, INC., DATE OF REVISION 10/25/01. "LANDS OF LCX JESSUP, L.P. —— ALTA/ASCH AS-BUILT SURVEY," AS PREPARED BY CIVIL DESIGN PARTNERS, INC., DATE OF REVISION OCTOBER 26, 2012. 7 BECOME 6-5 STONE CORNER -N/F 3100 105.04-010-031 105.04-010-031 MO005 UN STONES N/T COMMONNEALTH OF PA 116.04-010-001 NGIR, JC007021140 STONE CORNER BOUNDARY MAP OF CONSERVATION LANDS OF SCRANTON LACKAWANNA INDUSTRIAL BUILDING COMPANY SCALE :
DATE :
PROJ ENG :
DRAWN BY :
CHECKED BY :
DRAWING NO : SEALS Minor Subdivision Plan (Final Plan) DRAWING TITLE Sheet 3 of 4 Colwell-Naegele Associates, Inc. Communication of the state of t P.O. BOX B - CLARKS SUMMIT PENNSYLVANIA 18411 tolo: 570,586,5091 fox: 570,586,5073 JESSUP BOROUGH, C-2

ONSERVATZON PARCEL